


PLAT. NO. 4985

C & O RAILWAY CO.

PARCEL "D"
Churchill Town Sector
P.B. 95 P. 10413

N 24° 35' 41"E 304.20

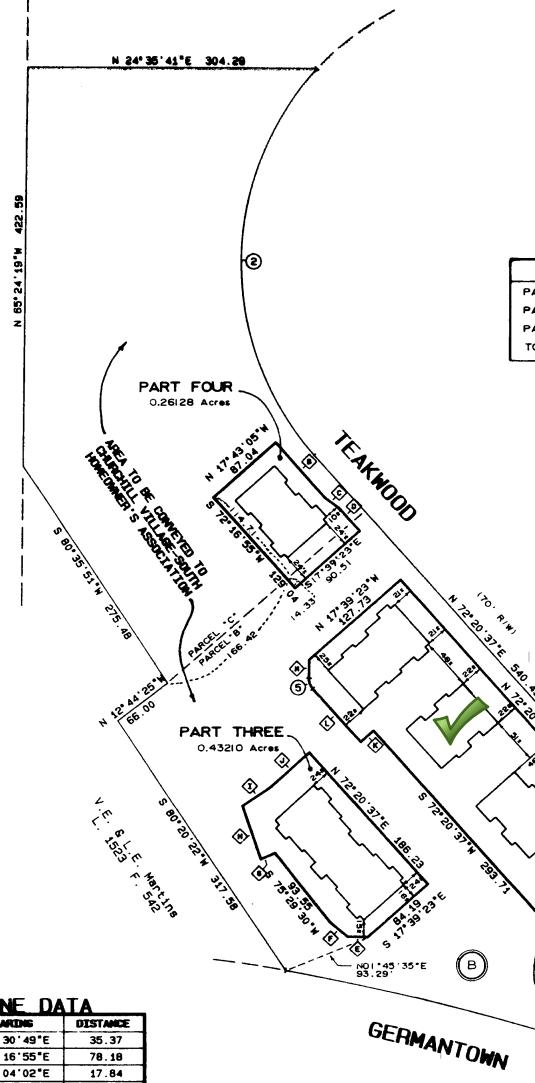

LINE DATA


BEARING	DISTANCE
N 21° 30' 49"E	35.37
N 72° 16' 55"E	78.18
N 61° 04' 02"E	17.84
N 72° 16' 55"E	33.46
S 25° 00' 15"W	21.06
S 64° 33' 23"W	23.92
S 0° 21' 43"E	16.26
N 64° 38' 05"W	59.60
N 09° 49' 48"W	35.49
N 17° 39' 23"W	54.83
S 17° 39' 23"E	18.00
S 72° 20' 37"E	75.21
N 65° 06' 29"W	19.24
S 23° 29' 11"E	41.23
S 61° 12' 09"W	18.00
N 58° 37' 37"E	18.00
S 48° 35' 00"W	22.16
S 66° 30' 49"W	57.00
N 68° 23' 50"W	24.50
N 51° 55' 11"W	11.18
N 23° 29' 11"W	45.00
N 66° 45' 32"E	29.10

NOTES

- General Common Elements shall be defined as set forth in the Declaration and shall include any property or improvements which are not part of any Unit or the Listed Common Elements as shown on this condominium plat.
- Please note that the property shown herein as "Area to be conveyed to Churchill Village-South Homeowner's Association" may be, but is not required to be, conveyed to the Churchill Village-South Homeowner's Association, Inc., and any such property shall not be a part of Willow Cove Manor Condominium.

RECORDED _____
CONDO. PLAT BOOK _____
PLAT _____

CURVE DATA					
DELTA	RADIUS	LENGTH	TANDEM	CHORD BEARING	CHORD DIST.
18° 07' 20"	2621.12	737.54	371.23	S 42° 33' 10"W	736.11
04° 10' 12"	305.00	448.06	275.44	S 65° 34' 17"E	408.84
08° 48' 48"	180.00	301.06	198.31	N 24° 26' 43"E	267.17
18° 26' 01"	137.33	44.18	22.26	S 63° 07' 37"W	43.98
40° 30' 08"	15.33	12.17	6.43	S 84° 54' 19"W	11.86
05° 18' 40"	672.42	62.33	31.19	S 26° 08' 31"E	62.31
02° 34' 32"	680.42	31.04	15.52	S 30° 05' 07"E	31.03

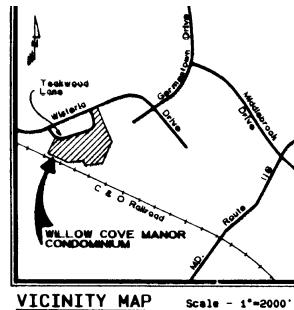

SURVEYOR'S CERTIFICATE


I hereby certify that this condominium plat consisting of 31 sheets is true to the best of my knowledge and belief, that it is a condominium subdivision of the buildings and other improvements situated on all of the following parcels:
 1) Parcel "A", Block "A" as shown on a plat of subdivision entitled "Plat 35, Churchill Town Sector" and recorded in Plat Book 95 as Plat 10410.
 2) Parcel "B", Block "B" as shown on a plat of subdivision entitled "Plat 36, Churchill Town Sector" and recorded in Plat Book 95 as Plat 10411 and
 3) Parcel "C", Block "B" as shown on a plat of subdivision entitled "Plat 37, Churchill Town Sector" and recorded in Plat Book 95 as Plat 10412,
 all of the aforementioned plats being among the Land Records of Montgomery County, Maryland.

I further certify that this plat has been prepared in accordance with the requirements as set forth in Title 11, Real Property Article of the Annotated Code of Maryland (1988 Cumulative Supplement).

I further certify that the location and dimensions of all existing improvements are as shown hereon and that there are no visible encroachments except as noted, and that this condominium plat, together with the applicable wording of the Declaration, is a correct representation of the condominium described and that the identification and location of each condominium unit and common elements, as constructed, can be determined from them.

August 25, 1988 Gerald L. Bennett
Date Gerald L. Bennett, Professional Land Surveyor, MD. No. 10743

AREA TABULATION	
PARCEL "A"	1.52169 Acres
PARCEL "B"	2.77576 . acres
PARCEL "C"	0.23151 Acres
TOTAL	4.52899 ACRES

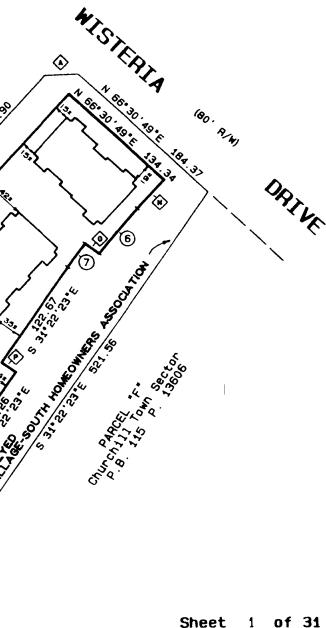

Sheet 1 of 31

WILLOW COVE MANOR CONDOMINIUM

Clarksburg (2nd) Election District
Montgomery County, Maryland

FILED
SEP 7 1988

Scale - 1"=100'

August, 1988

LOEDERMAN ASSOCIATES, INC.

CIVIL ENGINEERS LAND PLANNERS LAND SURVEYORS

15200 Shady Grove Road
Rockville, Maryland 20850
(301) 948-2750

